

5/18

<b>DART AEROSPACE LTD</b>	<b>Work Order:</b>	<b>22925</b>
<b>Description: Basket Rib</b>	<b>Part Number:</b>	<b>D3166-3</b>
<b>Dwg: D3166 Rev. A1</b> # KJ 01.05.21	<b>Qty:</b>	<b>10</b>
		Page 1 of 1

Step	Location	Procedure	By	Date	Qty
1	DC	Issue Traveller	KJ	05.04.06	10
2	LB	Cut 3/4" x 3/4" square tubing 120.00" long. Material: 304/316 SS tube 0.063" wall Batch <u>M12267/M12213</u>	DP	05/5/9	10
3	LB	Form D3166-3 Basket Hoop as per Dwg D3166 using Bending program 350 BASL. and Folio FT005	DP	05/5/9	10
4	QC6	Inspect Basket Hoop dimensions with template D3166-3-T1 (DT8303)	Z	05.05.10	10
5	LB	Identify and Stock LB Cell	MA	05/05/11	10
6	AC	Cost / part <u>26.95</u>	AL	05/05/12	10
7	DC	Close W/O <u>27.01</u> Inspect Level 21	QJ	05.05.16	10

Rev	Date	Change	Revised By	Approved
A	02.08.23	New issue	KJ RF	

RELEASED  
02/08/27 RF

W/O:		WORK ORDER CHANGES					
DATE	STEP	PROCEDURE CHANGE	By	Date	Qty	Approval Mfg / Design Mgr	Approval QC Inspector

NCR:		WORK ORDER NON-CONFORMANCE (NCR)						
DATE	STEP	Description of NC Section A	Corrective Action Section B			Verification Section C	Approval Design Mgr	Approval QC Inspector
			Initial Design Mgr	Action Description Design Mgr	Sign & Date			

Part No: \_\_\_\_\_ PAR #: \_\_\_\_\_ Fault Category: \_\_\_\_\_ NCR: Yes No DQA: \_\_\_\_\_ Date: \_\_\_\_\_


NOTE: Date & initial all entries

QA: N/C Closed: \_\_\_\_\_ Date: \_\_\_\_\_



DESIGN #	DRAWN BY CP	DART AEROSPACE LTD HAWKESBURY, ONTARIO, CANADA	
CHECKED #	APPROVED #	DRAWING NO. D3166	REV. A SHEET 1 OF 1
DATE 02.07.10		TITLE BASKET HOOP	SCALE NTS
A	02.07.10	NEW ISSUE	
A1	04.04.08	38+/-1 WAS 36.0	


RELEASED  
02.08.06

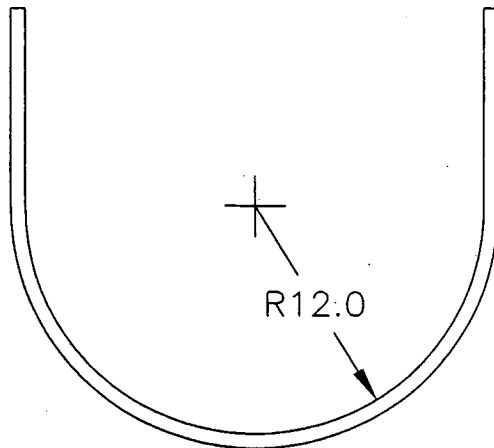

10.6 (REF, NEED 8.0 MIN)

D3166-1 BASKET HOOP

- 1) MATERIAL: AISI 304/316 SS SQUARE TUBING,  
0.75" x 0.75" x 0.063 WALL, 60.00" LONG  
(REF DART SPEC. M304TS0.750W.063)
- 2) FINISH: NONE
- 3) TOLERANCES ARE PER DART QSI 018 UNLESS  
OTHERWISE NOTED

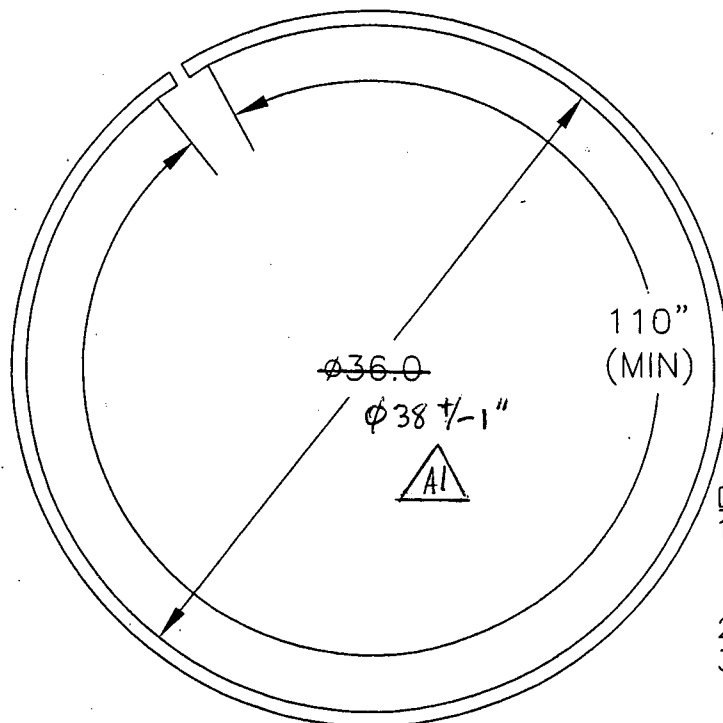

SHOP COPY  
TURN TO  
ENGINEERING  
UNCONTROLLED COPY  
SUBJECT TO AMENDMENT  
WITHOUT NOTICE

WORK ORDER  
NO. 22925

D3166-3 BASKET HOOP

- 1) MATERIAL: AISI 304/316 SS SQUARE TUBING,  
0.75" x 0.75" x 0.063 WALL, 120.00" LONG  
(REF DART SPEC. M304TS0.750W.063)
- 2) FINISH: NONE
- 3) TOLERANCES ARE PER DART QSI 018 UNLESS  
OTHERWISE NOTED

Copyright © 2002 by DART AEROSPACE LTD

THIS DOCUMENT IS PRIVATE AND CONFIDENTIAL AND IS SUPPLIED ON THE EXPRESS CONDITION THAT IT IS NOT TO BE USED FOR ANY PURPOSE OR COPIED OR COMMUNICATED TO ANY OTHER PERSON WITHOUT WRITTEN PERMISSION FROM DART AEROSPACE LTD.

# Job Costing Report

Dart Aerospace Ltd.  
Hawkesbury

Apr 04, 2005  
12:27 pm

Work Order No : 0022925  
Project Name : D3166-3  
Project For : WK518  
Work Order Type : Main  
Main WO Number :  
House Part Number : D3166-3  
Description : Basket Hoop  
Manufactured : Yes  
Amount Req'd : 10  
Amount Done : 0  
Start Date : 04-04-05  
Est Finish Date : 04-28-05  
Act Finish Date :  
Drawings Req'd : No  
Ok for Approval :  
Approval Rec'd :

Department Code:  
Burden Flags : NNNNNNNN  
WO Status : Open  
Invoice State : Not Invoiced  
Invoice Date :  
Invoice Number :  
Invoice Amount : 0.00  
Order Entry No :  
OE Value : 0.00  
Est Mark Up : 0.000%  
Actual Mark Up : 0.000%  
\$0 Posted to Finished Goods

	Estimated	Actual	Var. %	Posted	To Post
Material Cost :	0.00	0.00	0.00	0.00	0.00
Engineering Hours :	0.00	0.00	0.00		
Engineering Cost :	0.00	0.00	0.00	0.00	0.00
Production Hours :	0.00	0.00	0.00		
Production Cost :	0.00	0.00	0.00	0.00	0.00
Packaging Hours :	0.00	0.00	0.00		
Packaging Cost :	0.00	0.00	0.00	0.00	0.00
OverHead Hours :	0.00	0.00	0.00		
OverHead Cost :	0.00	0.00	0.00	0.00	0.00
CNC Hours :	0.00	0.00	0.00		
CNC :	0.00	0.00	0.00	0.00	0.00
Misc. Hours :	0.00	0.00	0.00		
Misc. :	0.00	0.00	0.00	0.00	0.00
Burden :	0.00	0.00	0.00		
Total Cost :	0.00	0.00	0.00		
Mark up :	0.000	0.000			
Selling Cost :	0.00	0.00			

	Estimated	Actual
Labour Hrs/Amount Done :	0.00	0.00
Profits/(Loss) :	0.00	0.00